


A-105
Canton City Council
DRAWING NUMBER
593.013
91051

DRAWING NUMBER

Figure 1

DRAWING NUMBER

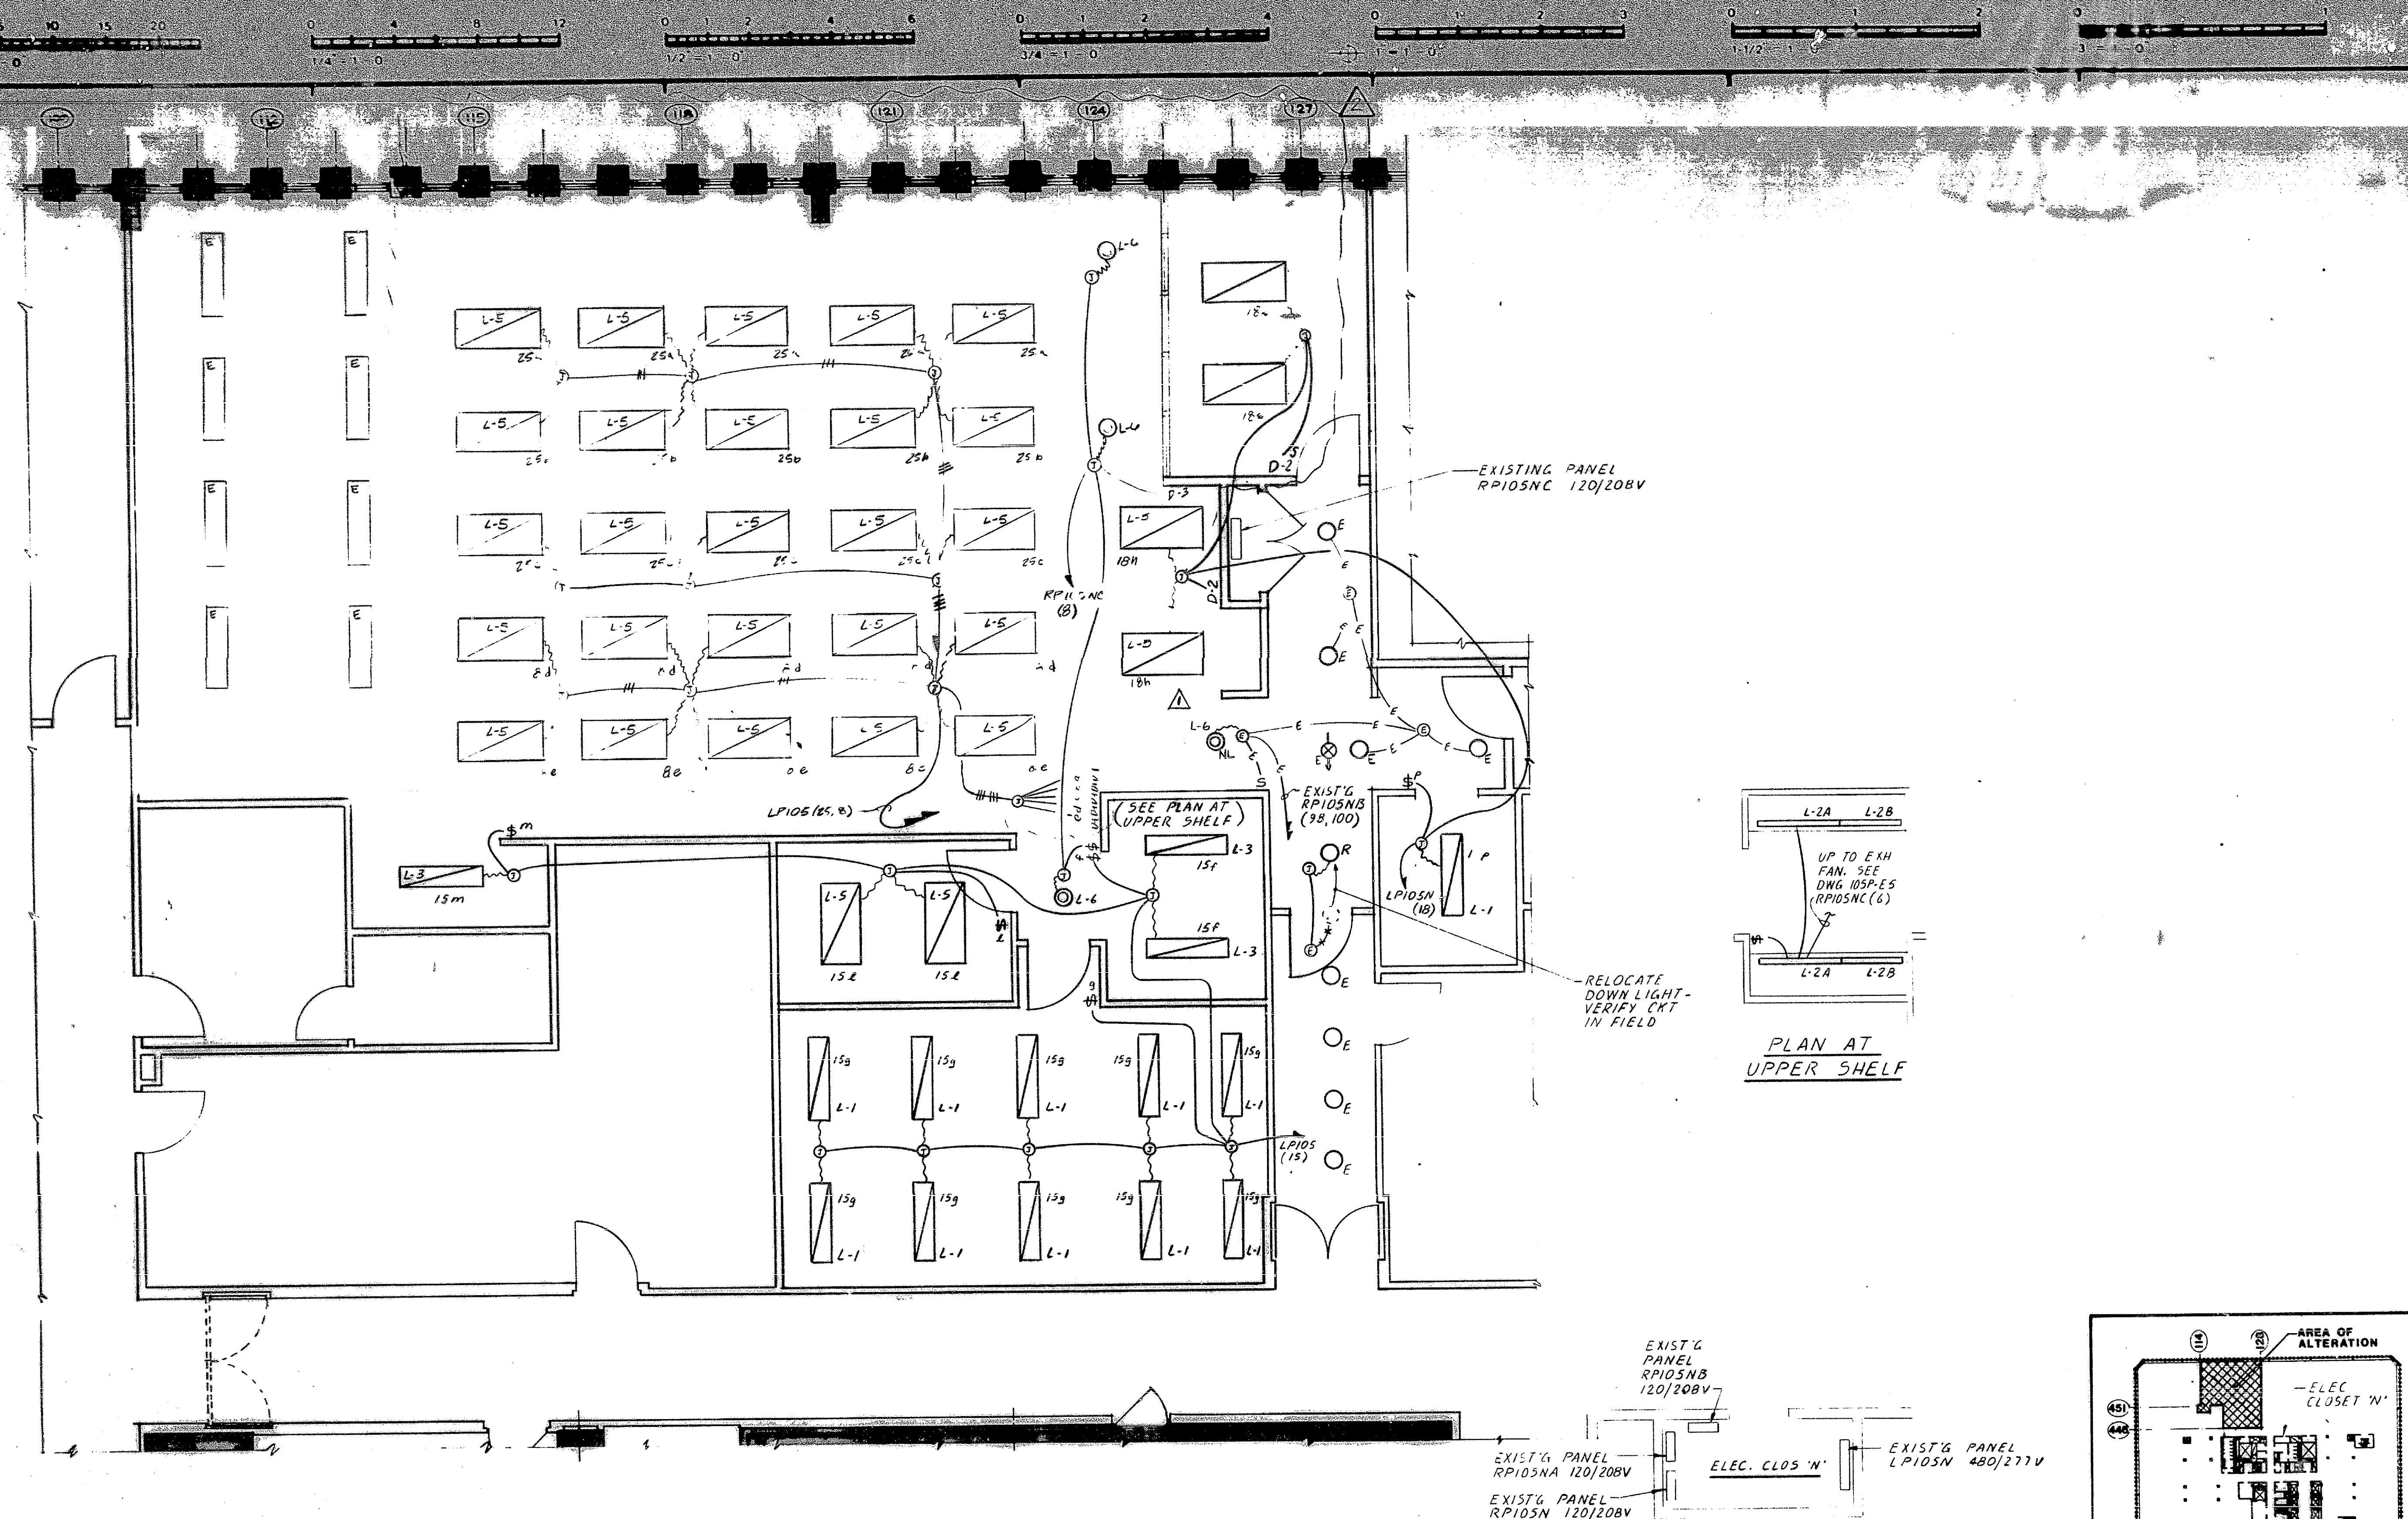

205 LEXINGTON AVE
NEW YORK NY 10016
TEL (212) 659 9550

CONSULTING ENGINEERS

07080 201 561-4770

DATE	ISSUED TO	PR.	TR.
1/22/91	PORT AUTHORITY FOR APPROVAL	10	1
1/27/91	CSEC FOR RECORD	2	1
	CONTRACTORS FOR BIDDING	4	4
5/3/91	P.A. FOR APPROVAL	10	—
6-19-91	PORT AUTHORITY	10	1
10-21-91	P.A. AS BUILT DRAWING	—	—

**JOHN C. WESTRICK & ASSOCIATES
CONSULTING ENGINEERS
2110 MAPLE AVENUE
SOUTH PLAINFIELD, N.J. 07080
561-4170**

AS BUILT DRAWINGS


Signature _____ Date _____

C	26-91	AS PER AS-BUILT CONDITIONS	FE
I	4-28-91	AS PER P.A. COMMENTS	FE
NO	DATE	REVISION	

**CANTOR, FITZGERALD
SECURITIES CORP.**
105th FLOOR
ONE WORLD TRADE CENTER, NEW YORK, N.Y.

PROPOSED NEW TRADING ROOM FOR INVESTMENT STRATEGIES

LIGHTING PLAN

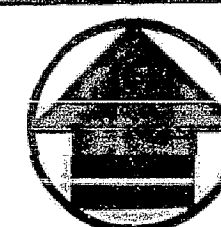

NORTH

PROJECT NO. 9115

SCALE 1/4" = 1'-0"

DRAWN BY GCD...

CHECKED BY JGW

DATE 3-20-91

DRAWING NO.

105P E-4

KEY PLAN

$$1/64 = 1 \cdot 0$$

PHASE

11

1000

1

